
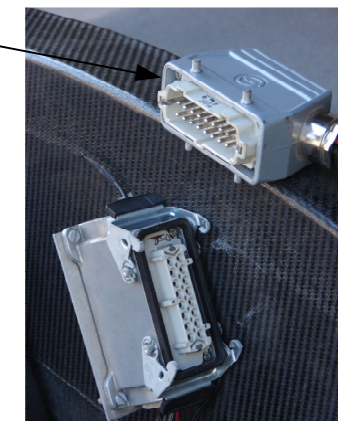
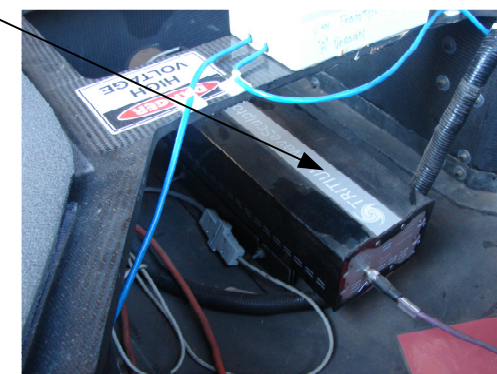
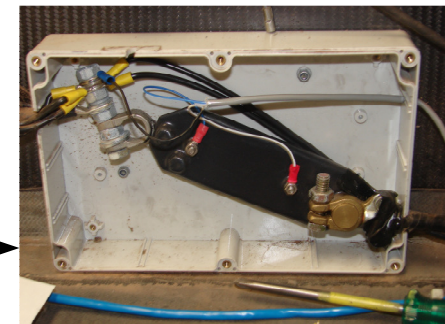
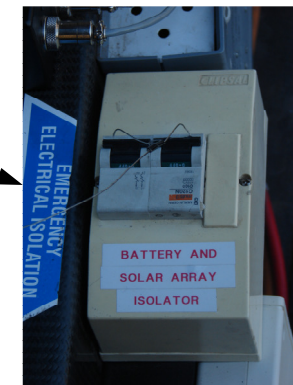
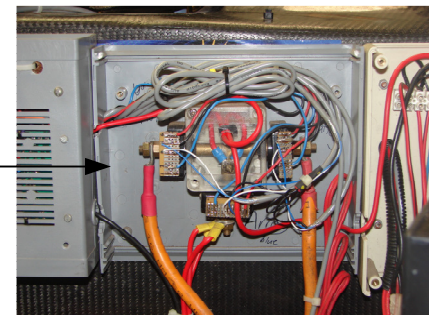
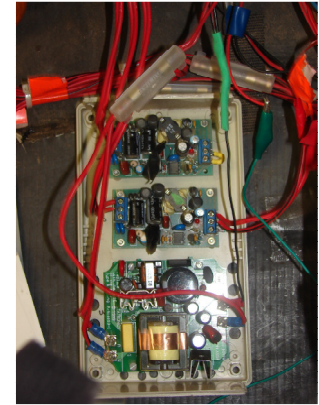
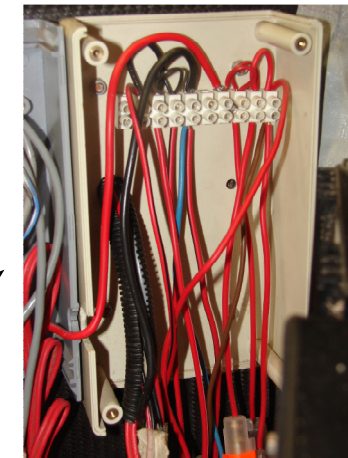
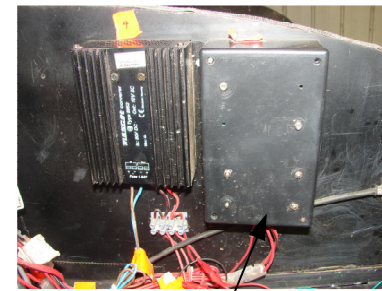


Kelly DC Supply Hardware Locations

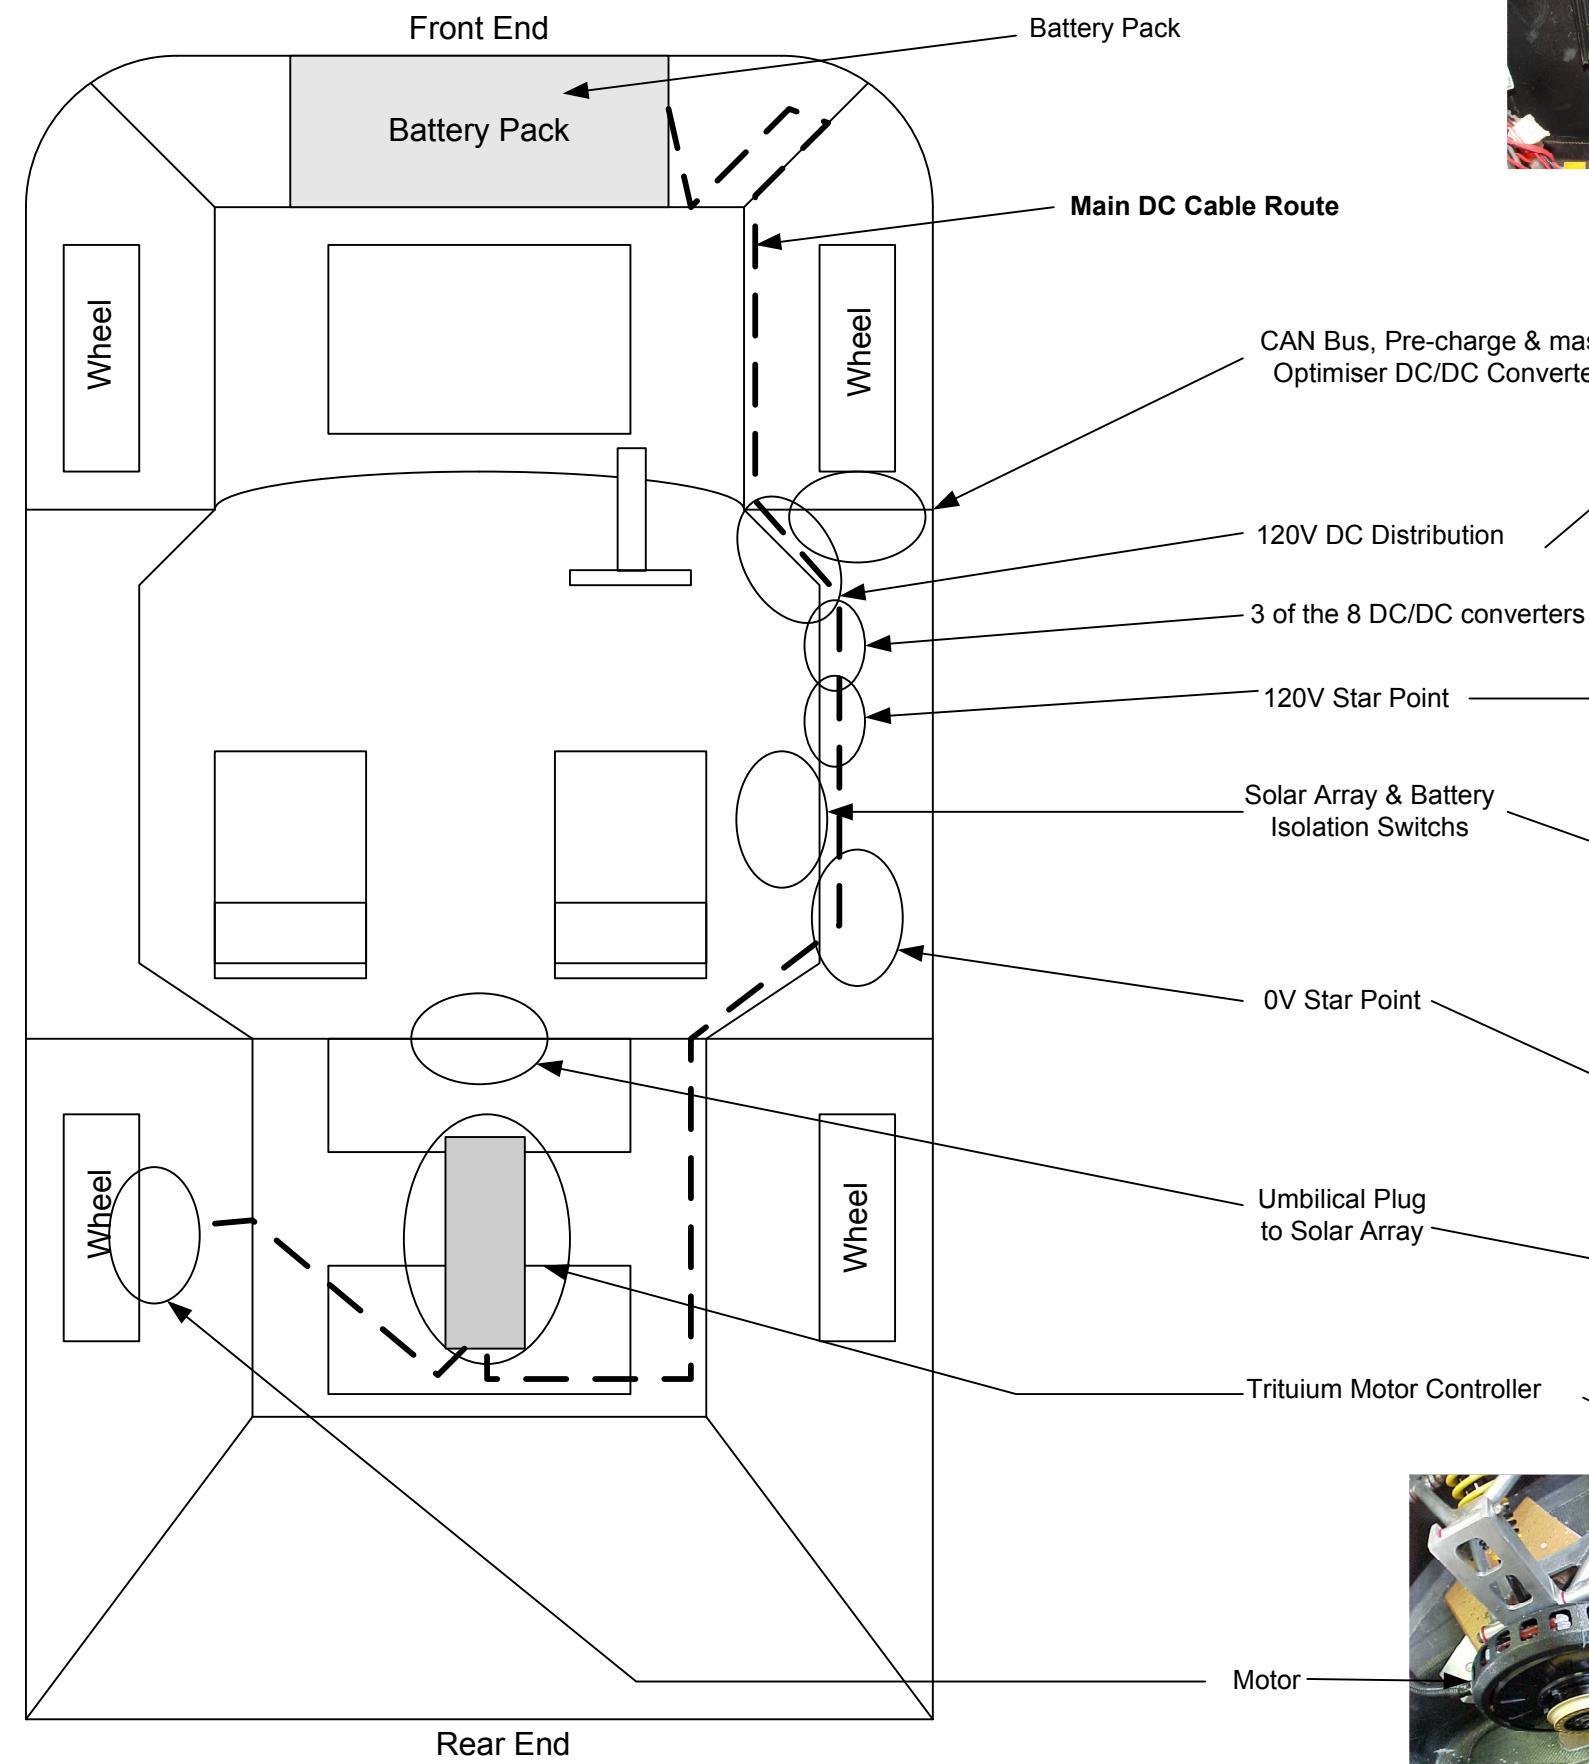

Note: Kelly not to scale, Diagrammatic representation only.
CAN Nodes in approximate position. Visual location required.

Do Not Use this Drawing for Solar Spirit

“Kelly” – DC Power Locations – As Built

Drawn By Ian Rowley Drawn 13/8/09 Version B Sht 2 of 2