

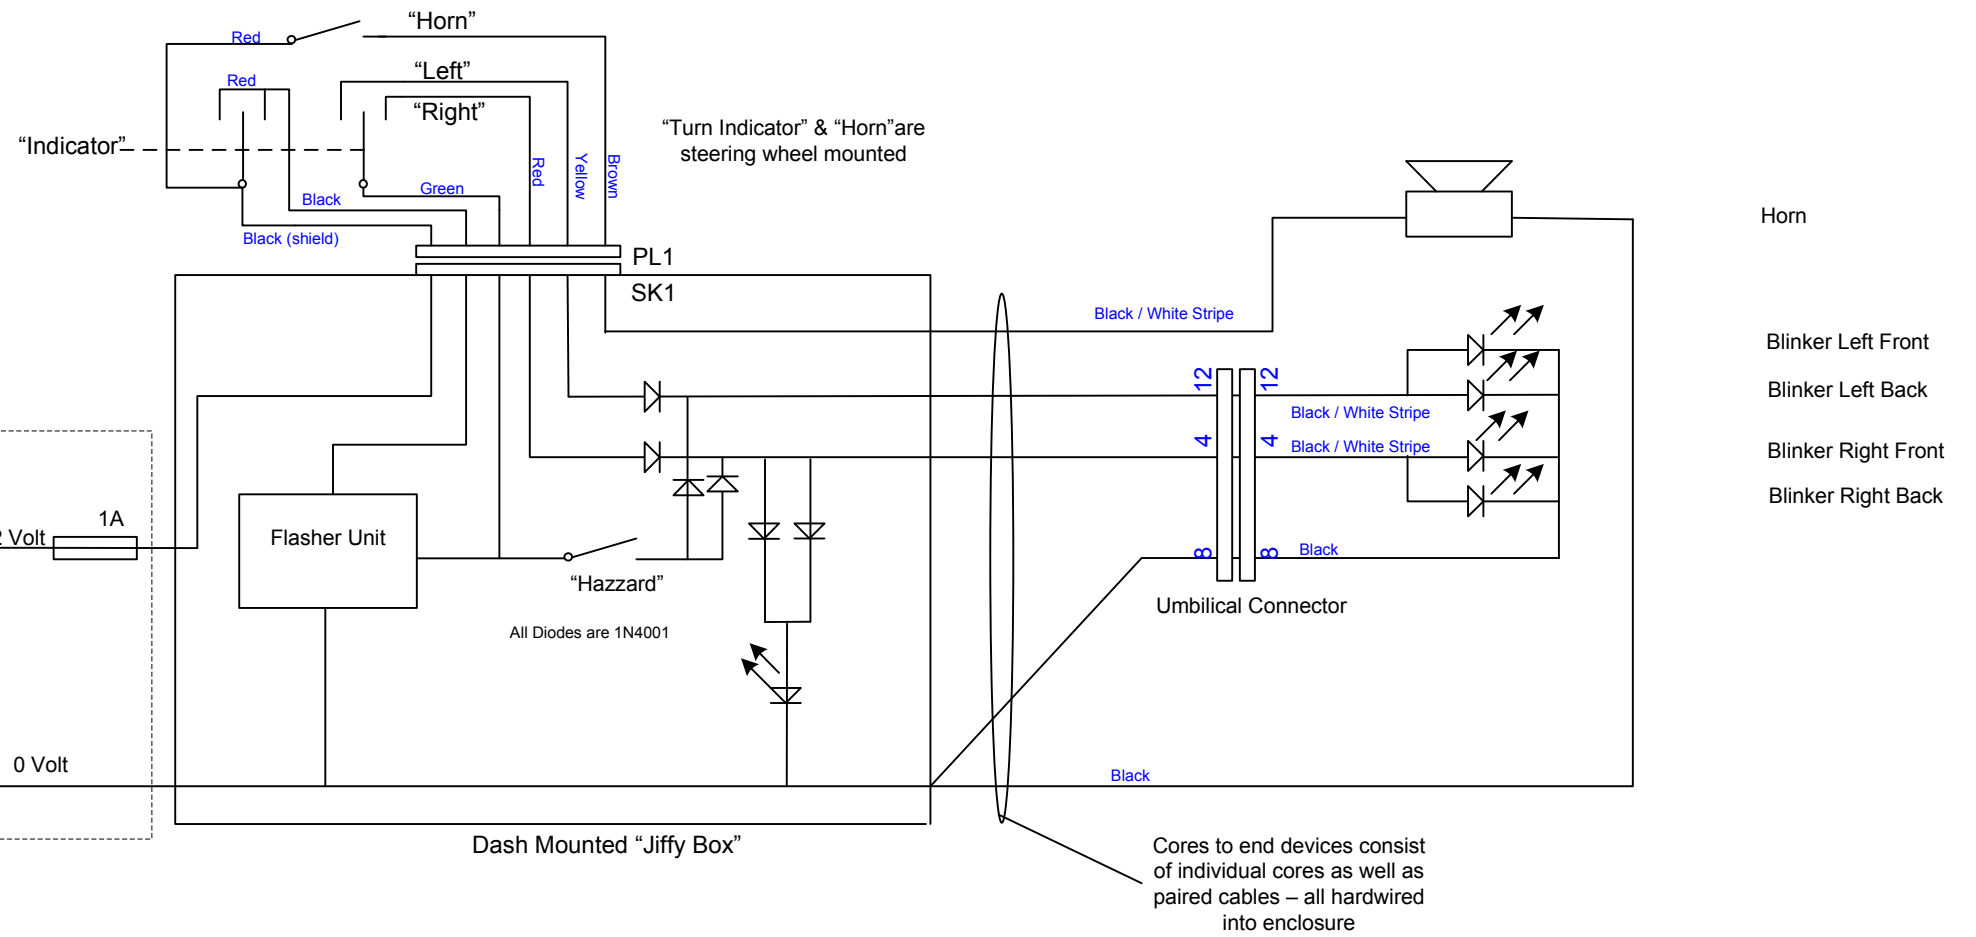
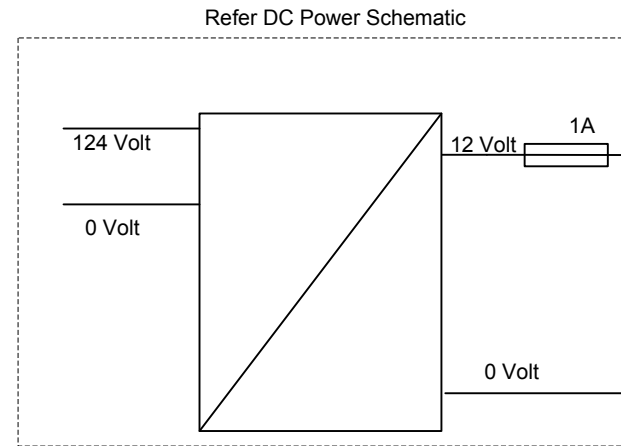




Indicator & Horn Interface

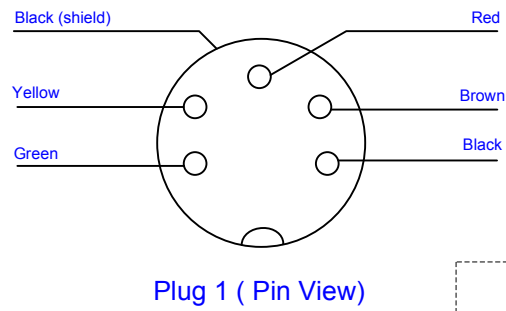

CAN Driver Controller to Driver Interface Connections

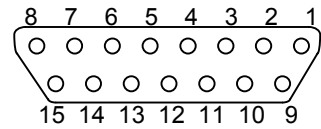

To be Developed

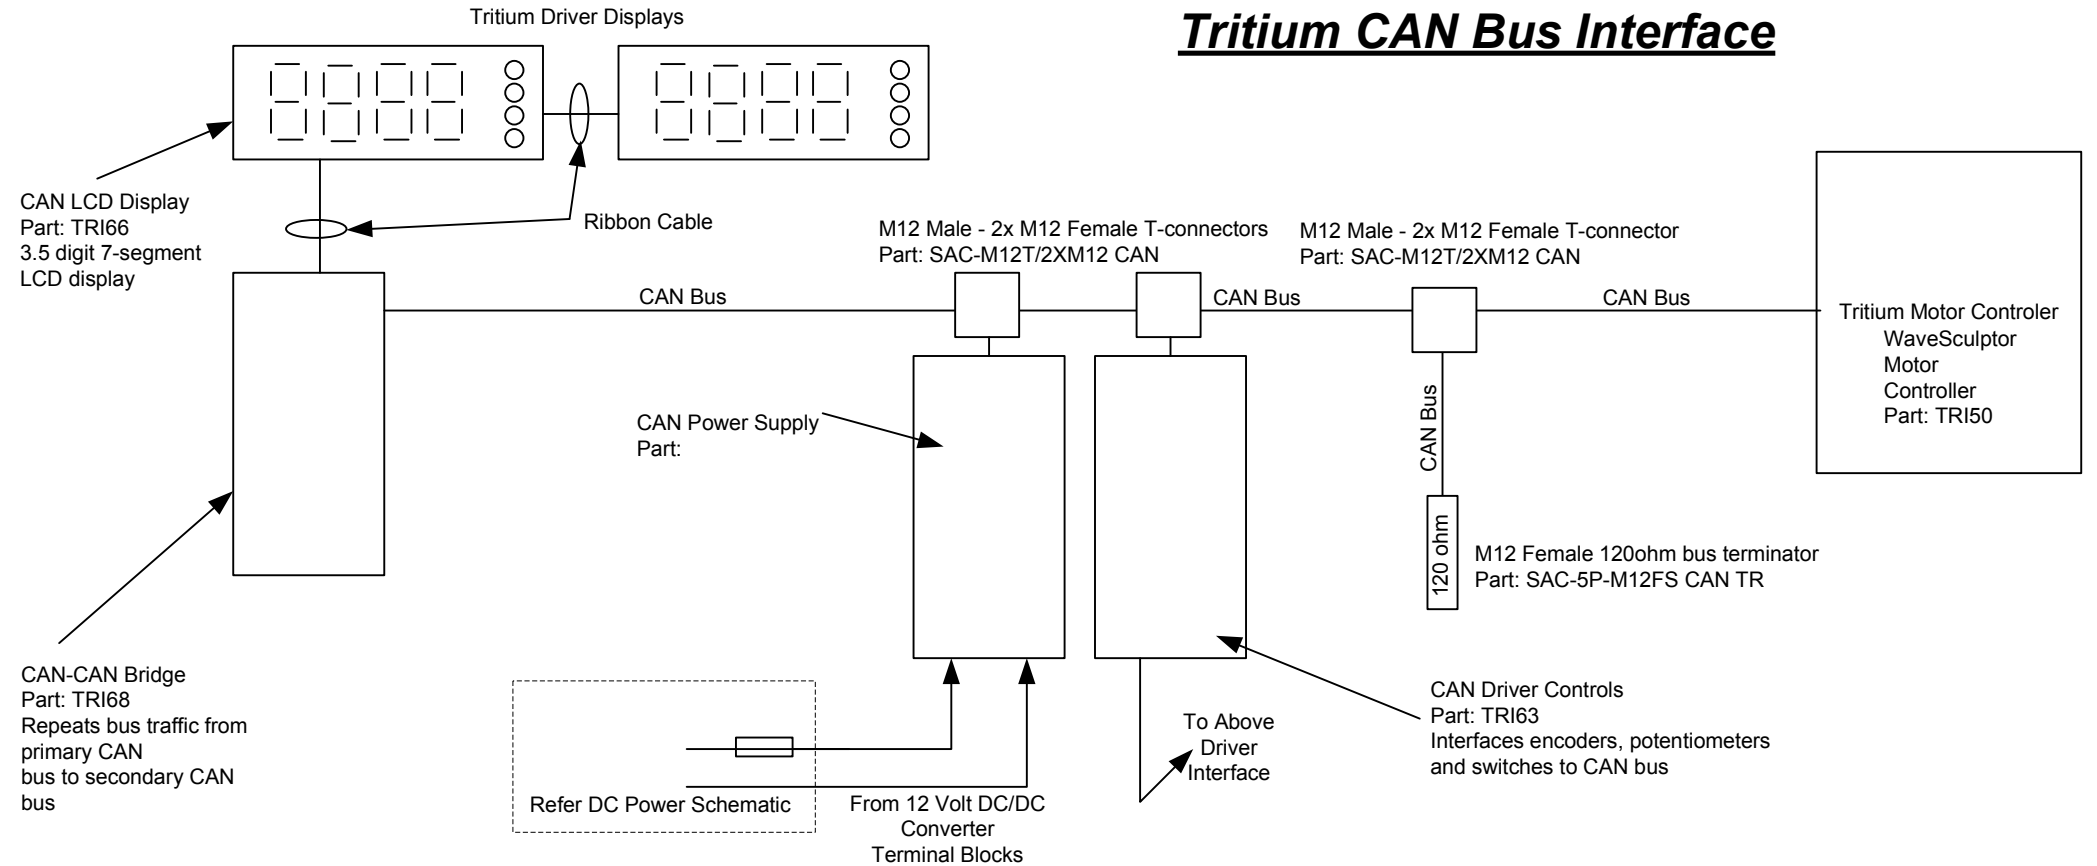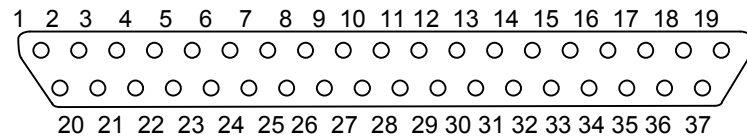

- Notes:-
1. This drawing reflects all design inputs currently known at the time.
 2. This schematic should not be considered as complete
 3. Drawing not to scale.

"Kelly" – Tritium CAN Bus, Horn & Indicator Interface – As built

Revisions:
A Issued as draft
B Added wiring details for steering controls & other general information.

Do Not Use for Solar Spirit
Drawn By Ian Rowley | Drawn 25/9/09 | Version B | Sht 1 of 1